

Date: Monday, 6/5/2006 7:48:01 AM
 User: Kim Johnston

Process Sheet

Customer : CU-DAR001 Dart Helicopters Services Drawing Name : DOUBLER
 Job Number : 27379
 Estimate Number : 11468
 P.O. Number : N/A Part Number : D314097
 This Issue : 6/5/2006 S.O. No. : N/A Drawing Number : D3140 REV D1
 Prsht Rev. : NC Project Number : N/A
 First Issue : N/A Type : MACHINED PARTS Drawing Revision : D1
 Previous Run : 26724 Material : N/A
 Due Date : 6/30/2006 Qty: 4 Um: Each
 Written By : *See Comment Below*
 Checked & Approved By : *06.06.05*
 Comment : Est. A02.04.30 New Issue NG
 Est. Rev B New dwg rev. ecn781 06.04.18 EC

Additional Product

Job Number:



Seq. #: Machine Or Operation: Description :

1.0 M2024T3S032 2024-T3 .032 sheet



Comment: Qty.: 0.1796 sf(s)/Unit Total : 0.7182 sf(s)

2024-T3 .032 sheet

Matl: 2024-T3 (QQ-A-250/4) .032" thick
 (M2024T3S.032)

Batch *M100284*

MM 06 06 08

2.0 SHEAR SHEAR



N/A



Comment: SHEAR

Cut blanks

Blank size: 3.810" x 6.43" x .032" thick Grain along 3.810"

3.0 HAAS1 HAAS CNC VERTICAL MACHINING #1



Comment: HAAS CNC VERTICAL MACHINING #1

Machine as per Folio FA226

Stack of 10

Deburr break all unmarked sharp edges .005 to 0.010

Form as per dwg (-97 shown)

Waterjet
Dwg Rev 01
Prog Rev 01

MM 06 06 08

4.0 ~~QC5~~ QC2 INSPECT WORK TO CURRENT STEP



Comment: INSPECT WORK TO CURRENT STEP

MM 06 06 08







4.1 QC8 Second check.


06.06.12

(4)

(10)

W/O:		WORK ORDER CHANGES					
DATE	STEP	PROCEDURE CHANGE	By	Date	Qty	Approval Mfg / Design Mgr	Approval QC Inspector

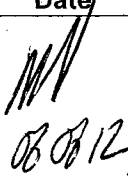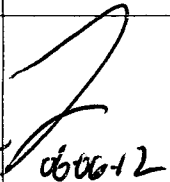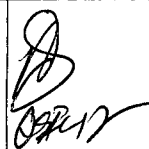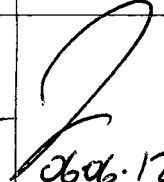NCR:		WORK ORDER NON-CONFORMANCE (NCR)						
DATE	STEP	Description of NC Section A	Corrective Action Section B			Verification Section C	Approval Design Mgr	Approval QC Inspector
			Initial Design Mgr	Action Description Design Mgr	Sign & Date			
06.12	B	1 part cut cross hole across top section at piercing point. Part unacceptable. 		Scrap: des tray. Took 1 from - 97 for banding.	 06.12	 06.12	 06.12	 06.12

Part No: _____ PAR #: _____ Fault Category: _____ NCR: Yes ☒ No ☐ DQA:  Date: 06/06/15

NOTE: Date & initial all entries QA: N/C Closed: _____ Date: _____

Date: Monday, 6/5/2006 7:48:01 AM
User: Kim Johnston

Process Sheet

Customer: CU-DAR001 Dart Helicopters Services

Drawing Name: DOUBLER

Job Number: 27379

Part Number: D314097

Job Number:



Seq. #:

Machine Or Operation:

Description :

5.0

HAND FINISHING1

HAND FINISHING RESOURCE #1



Comment: HAND FINISHING RESOURCE #1

Chemical Conversion Coat as per QSI 005 4.1

H.M 06/06/14

(4)

6.0

QC3

INSPECT POWDER COAT/CHEMICAL CONVERSION



Comment: INSPECT POWDER COAT/CHEMICAL CONVERSION

06/06/14 (4)

7.0

PACKAGING 1

PACKAGING RESOURCE #1



Comment: PACKAGING RESOURCE #1

Identify and Stock

Location: /

06/06/14 (4)

8.0

DC

DOCUMENT CONTROL



Comment: DOCUMENT CONTROL

Inspection Level 21

06/06/15 (4)
W 06-06-15

Job Completion



4.2 Small FAB.
Form AS per DW 3190.

06/06/13 (4)

4.3. QCS 20-06-13 (4)

W/O:		WORK ORDER CHANGES					
DATE	STEP	PROCEDURE CHANGE	By	Date	Qty	Approval Mfg / Design Mgr	Approval QC Inspector

NCR:		WORK ORDER NON-CONFORMANCE (NCR)						
DATE	STEP	Description of NC Section A	Corrective Action Section B			Verification Section C	Approval Design Mgr	Approval QC Inspector
			Initial Design Mgr	Action Description Design Mgr	Sign & Date			

Part No: _____ PAR #: _____ Fault Category: _____ NCR: Yes No DQA: _____ Date: _____

NOTE: Date & initial all entries

QA: N/C Closed: _____ Date: _____



DESIGN DS	DRAWN BY RF	DART AEROSPACE LTD HAWKESBURY, ONTARIO, CANADA	
CHECKED <i>[Signature]</i>	APPROVED <i>[Signature]</i>	DRAWING NO. D3140	REV. D SHEET 1 OF 7
DATE 05.11.23		TITLE DOOR	SCALE NTS
A	02.04.18	NEW ISSUE	
B	03.01.23	REMOVE -65/-81/-83; ADD -301/-303	
C	04.11.08	CHANGE DELASTEK SPEC. TEC-77; ADD PART MARKING; ADD NOTES 11, 12, 13; CHANGE ANGLE -95/-97/-98 TO 106°	
D	05.11.23	ADD -103/-104/-105/-106; REMOVE -67	
DI	06.03.31	1.75 WAS 1.88; 4.75 WAS 4.13	

RELEASED
05.12.01 *[Signature]*

QTY -05	QTY -06	QTY -07	QTY -08	QTY -09	QTY -10	PART NUMBER	DESCRIPTION
X						D3140-05	DOOR
	X					D3140-06	DOOR
		X				D3140-07	DOOR
			X			D3140-08	DOOR
		1		X		D3140-09	DOUBLER ASSEMBLY
			1		X	D3140-10	DOUBLER ASSEMBLY
3	3					D3140-57	PAD
1	1					D3140-59	PAD
2	2					D3140-61	PAD
2	2					D3140-63	PAD
		1	1			D3140-69	PAD
		1	1			D3140-71	PAD
		1	1			D3140-73	PAD
		1	1			D3140-75	PAD
		1	1			D3140-77	PAD
		1	1			D3140-79	PAD
				1	1	D3140-85	ANGLE
1	1					D3140-87	DOUBLER
				1	1	D3140-89	DOUBLER
		1				D3140-91	DOUBLER
			1			D3140-92	DOUBLER
3	3					D3140-95	DOUBLER
1						D3140-97	DOUBLER
	1					D3140-98	DOUBLER
		1	1			D3140-99	DOUBLER
		2	2			D3140-101	DOUBLER
		1				D3140-103	DOUBLER
			1			D3140-104	DOUBLER
		1				D3140-105	DOUBLER
			1			D3140-106	DOUBLER
1	1					D3140-241	DOUBLER
1		1				D3140-301	DOUBLER
	1		1			D3140-303	DOUBLER
				5	5	MS20426AD3-4	RIVET



SHOP COPY
RETURN TO
ENGINEERING
UNCONTROLLED COPY
SUBJECT TO AMENDMENT
WITHOUT NOTICE
WORK ORDER

Copyright © 2002 by DART AEROSPACE LTD

NO. 27349

THIS DOCUMENT IS PRIVATE AND CONFIDENTIAL AND IS SUPPLIED ON THE EXPRESS CONDITION THAT IT IS NOT TO BE USED FOR ANY PURPOSE OR COPIED OR COMMUNICATED TO ANY OTHER PERSON WITHOUT WRITTEN PERMISSION FROM DART AEROSPACE LTD.

DART

DESIGN DS	DRAWN BY RF	DART AEROSPACE LTD HAWKESBURY, ONTARIO, CANADA	
CHECKED <i>[Signature]</i>	APPROVED <i>[Signature]</i>	DRAWING NO. D3140	REV. 0 SHEET 2 OF 7
DATE 05.11.23		TITLE DOOR	SCALE NTS

1

COMPOSITE LAYUP & BONDING I.A.W. DELASTEK PROCESS SPEC. TEC-77
MATERIAL STORAGE & HANDLING TO BE I.A.W. DART QSI 006
MAIN LAYUP USES FIBERCOTE E-761/7781 EPOXY FIBERGLASS.
FILL WITH EPOCAST 87269 OR MAGNOBOND 77 A & B AND MA560 FOAM/ NB-51/30 FOAM

2

FINISH: DUPONT HIGHBUILD GREY PRIMER 1144-S

3

MAKE PARTS IN ACCORDANCE WITH THE FOLLOWING TOOLS/MOLDS:

PART	TOOL
D3140-05	B30-23000-01T
D3140-06	B30-23000-02T
D3140-07	B30-23000-03T
D3140-08	B30-23000-04T
D3140-57	B30-23000-57T
D3140-61	B30-23000-61T
D3140-63	B30-23000-63T
D3140-69	B30-23000-69T
D3140-71	B30-23000-71T
D3140-73	B30-23000-73T
D3140-75	B30-23000-75T
D3140-77	B30-23000-77T
D3140-79	B30-23000-79T
D3140-89	D3140-89T1
D3140-301	D3140-301T1
D3140-303	D3140-303T1

RELEASED
05.12.01

4

MATERIAL: 2024-T3 (QQ-A-250/4) 0.032 THICK (M2024T3S.032)
FINISH: CHEMICAL CONVERSION COAT PER DART QSI 005 4.1

5

MATERIAL: 2024-T3 (QQ-A-250/4) 0.020 THICK (M2024T3S.020)
FINISH: CHEMICAL CONVERSION COAT PER DART QSI 005 4.1

6

MATERIAL: 5052-H32/H34 (QQ-A-250/8) 0.040 THICK (M5052H32S.040)
FINISH: CHEMICAL CONVERSION COAT PER DART QSI 005 4.1

7

MATERIAL: POLIMEX TR75 1" THICK 4.5 LB KLEGECELL

8

ALL DIMENSIONS IN INCHES

9

TOLERANCES ARE PER DART QSI 018 UNLESS OTHERWISE NOTED

10

MATERIAL: 6061-T6 (QQ-A-250/11) 0.063 THICK (M6061-T6S.063)
FINISH: CHEMICAL CONVERSION COAT PER DART QSI 005 4.1

11

DOUBLER TO SIT ON TOP OF FOAM AT THIS LOCATION

12

DOUBLER TO BE RECESSED FLUSH INTO FOAM AT THIS LOCATION



13

RUBBER STAMP WITH DART P/N D3140-05/-06/-07/-08 USING MIL-STD-130


SHOP COPY
RETURN TO
ENGINEERING
UNCONTROLLED COPY
SUBJECT TO AMENDMENT
WITHOUT NOTICE
WORK ORDER
NO. 27379

Copyright © 2002 by DART AEROSPACE LTD


THIS DOCUMENT IS PRIVATE AND CONFIDENTIAL AND IS SUPPLIED ON THE EXPRESS CONDITION THAT IT IS NOT TO BE USED FOR ANY PURPOSE OR COPIED OR COMMUNICATED TO ANY OTHER PERSON WITHOUT WRITTEN PERMISSION FROM DART AEROSPACE LTD.

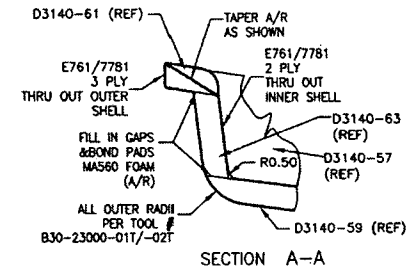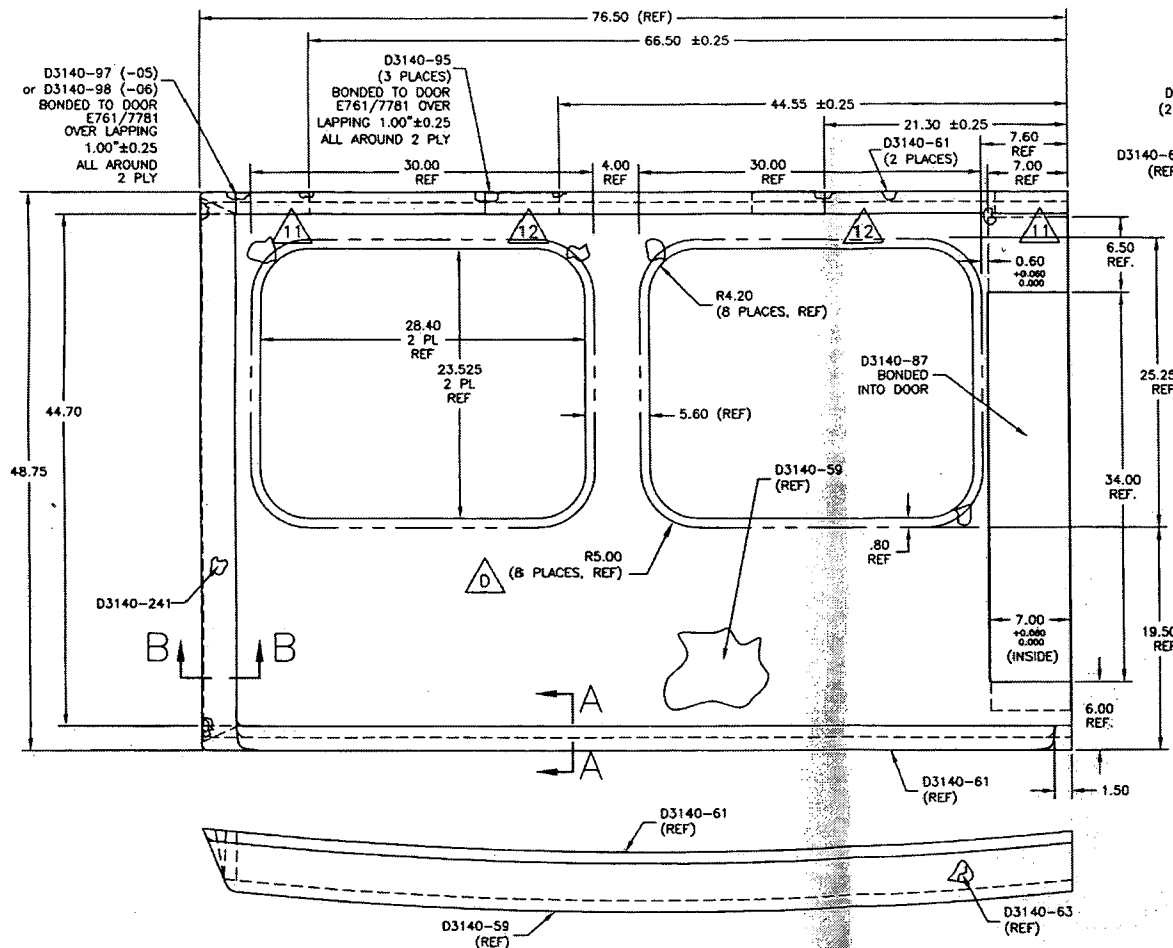

RELEASED
05.12.01

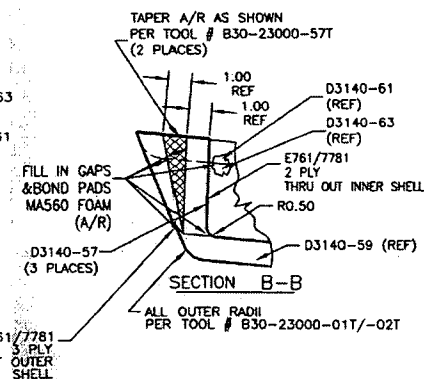

D3140-05 DOOR (SHOWN, REPLACES PREMIER P/N B30-23000-05)
D3140-06 DOOR (OPPOSITE, REPLACES PREMIER P/N B30-23000-06)
(WINDOWS & CUTOUTS TO BE LOCATED PER B30-23000-01T/-02T TOOL)


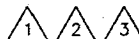


COPYRIGHT © 2002 BY DART AEROSPACE LTD.

THIS DOCUMENT IS PRIVATE AND CONFIDENTIAL AND IS SUPPLIED ON THE EXPRESS CONDITION THAT IT IS NOT TO BE USED FOR ANY PURPOSE OR COPIED OR COMMUNICATED TO ANY OTHER PERSON WITHOUT WRITTEN PERMISSION FROM DART AEROSPACE LTD.


DESIGN DS	DRAWN BY RF	DART	DART AEROSPACE LTD. WARRICKBURY, OXFORD, CANADA
CHECKED H	APPROVED H	DRAWING NO. D3140	REV. D SHEET 3 OF 7
DATE 05.11.23	TITLE DOOR	SCALE NTS	

NO. 21379
WORK ORDER
SUBJECT TO AMENDMENT
WITHOUT NOTICE
UNCONTROLLED COPY
ENGINEERING
RETURN TO
SHOP COPY

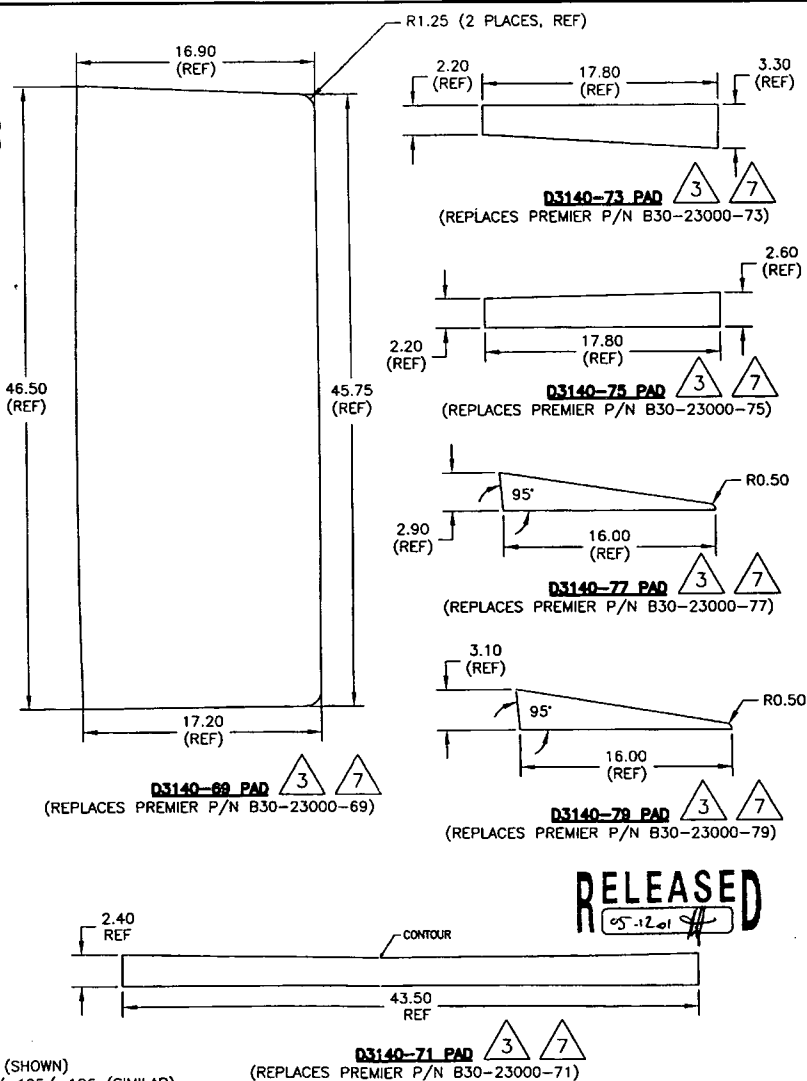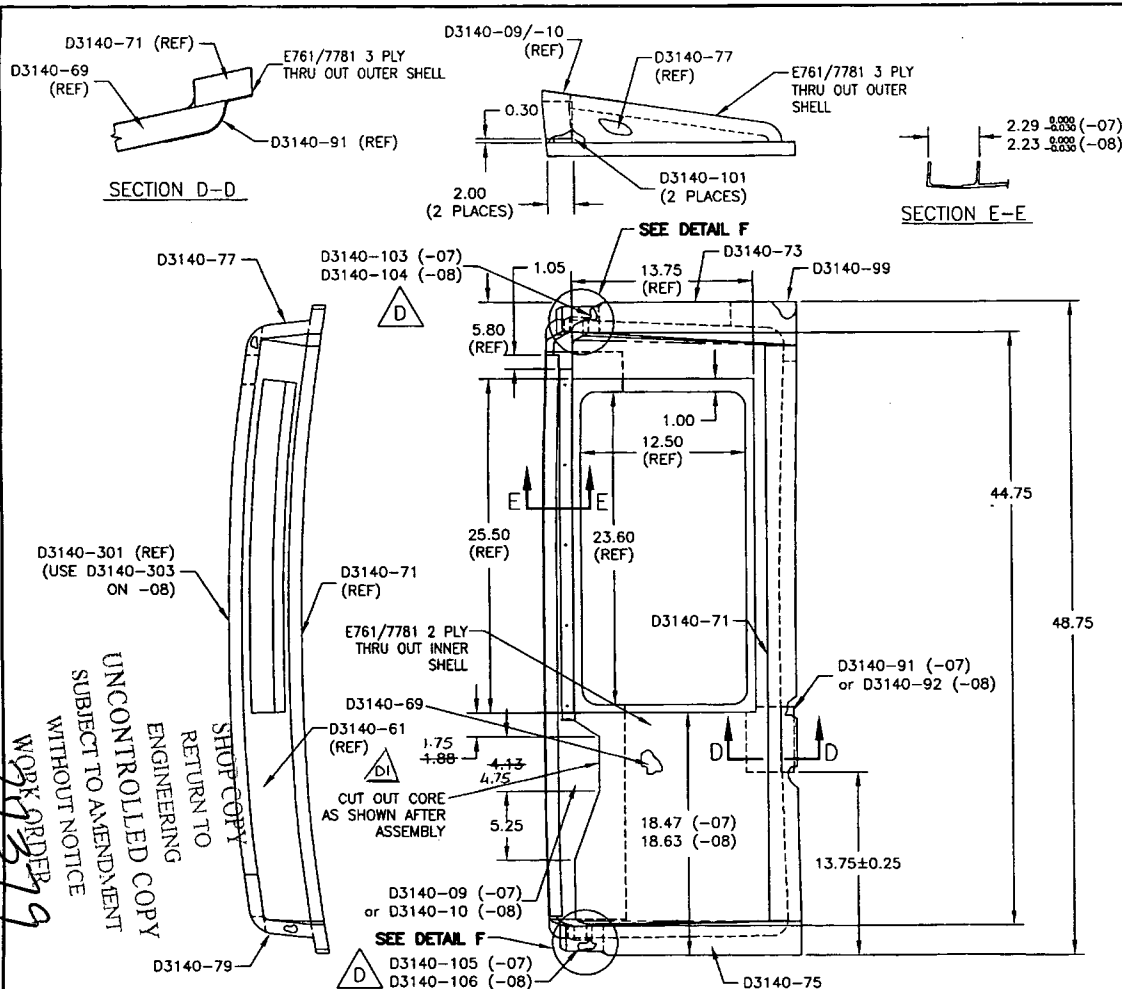


D3140-07 DOOR (SHOWN, REPLACES PREMIER P/N B30-23000-07)
D3140-08 (OPPOSITE, REPLACES PREMIER P/N B30-23000-08)
(WINDOW TO BE LOCATED BY TOOL B30-23000-03T/-04T)

1 2 3

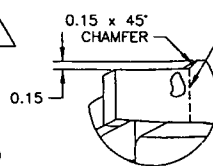


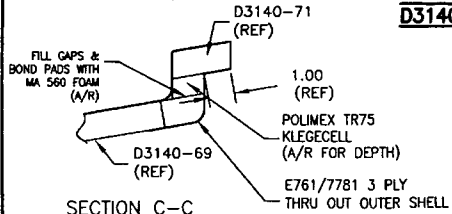

DETAIL F
(TYPICAL 2 PLACES)




 SECTION C-C


RELEASED
05-12-01

COPYRIGHT © 2002 BY DART AEROSPACE LTD.		DESIGN DS	DRAWN BY RF		DART AEROSPACE LTD. MARKHAM, ONTARIO, CANADA	
THIS DOCUMENT IS PRIVATE AND CONFIDENTIAL AND IS SUPPLIED ON THE EXPRESS CONDITION THAT IT IS NOT TO BE USED FOR ANY PURPOSE OR COPIED OR COMMUNICATED TO ANY OTHER PERSON WITHOUT WRITTEN PERMISSION FROM DART AEROSPACE LTD.		CHECKED 	APPROVED 	DRAWING NO. D3140	REV. D	SHEET 4 OF 7
		DATE 05.11.23	TITLE DOOR	SCALE N.T.S.		


NO. 29379
WORK ORDER
SUBJECT TO AMENDMENT
WITHOUT NOTICE
ENGINEERING
RETURN TO
SHOP COPY

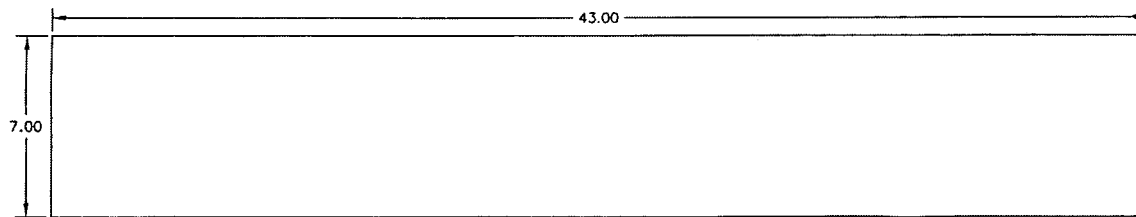


D3140-87 DOUBLER $\triangle 4$
(REPLACES PREMIER P/N B30-23000-87)

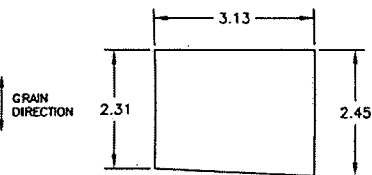


D3140-105F FLAT PATTERN
(USED TO MAKE D3140-105/-106 BRACKETS)

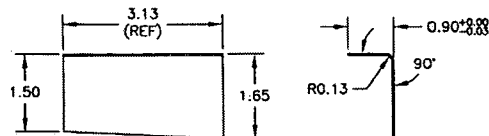

D3140-105 DOUBLER $\triangle 4$ $\triangle D$
D3140-106 OPPOSITE

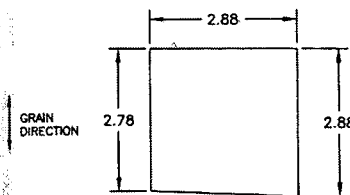


D3140-103F FLAT PATTERN
(USED TO MAKE D3140-103/-104 BRACKETS)

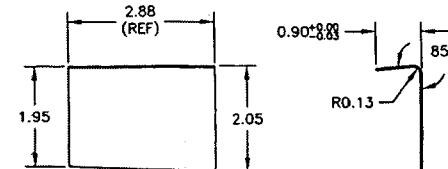


D3140-103 DOUBLER $\triangle 4$ $\triangle D$
D3140-104 OPPOSITE


D3159-3F FLAT PATTERN
(USED TO MAKE D3159-3/-4 BRACKETS)

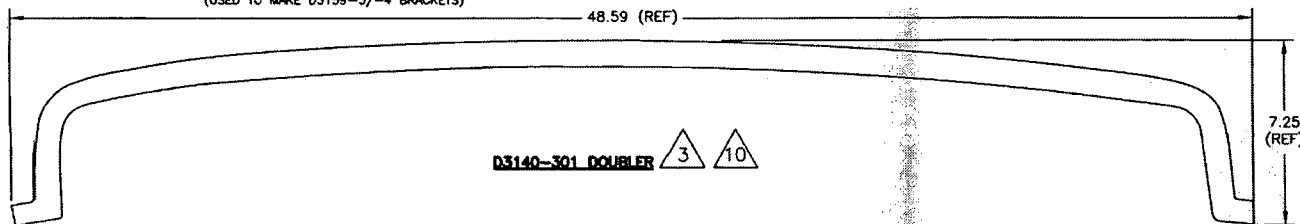

D3140-301 DOUBLER $\triangle 3$ $\triangle 10$

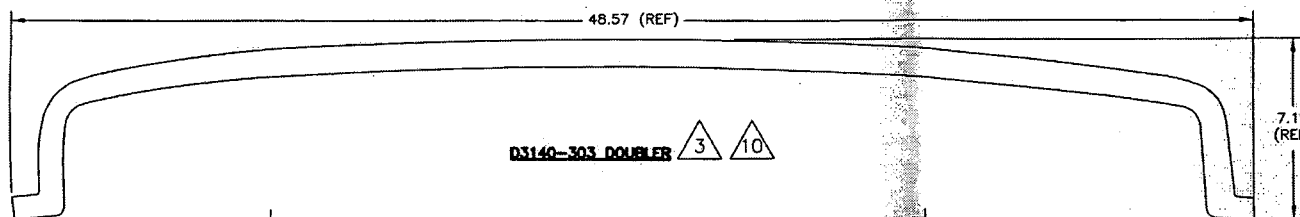

D3140-303 DOUBLER $\triangle 3$ $\triangle 10$

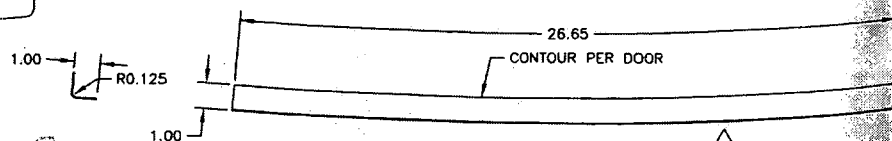

D3140-85 ANGLE $\triangle 6$
FLAT PATTERN: 26.65" x 1.90"
(REPLACES PREMIER P/N B30-23000-85)



RELEASED
05.12.01

COPYRIGHT © 2002 BY DART AEROSPACE LTD.

THIS DOCUMENT IS PRIVATE AND CONFIDENTIAL AND IS SUPPLIED ON THE EXPRESS CONDITION THAT IT IS NOT TO BE USED FOR ANY PURPOSE OR COPIED OR COMMUNICATED TO ANY OTHER PERSON WITHOUT WRITTEN PERMISSION FROM DART AEROSPACE LTD.

DESIGN DS	DRAWN BY RF	DART DART AEROSPACE LTD. HAMMERSLEY, ONTARIO, CANADA	REV. D
CHECKED [Signature]	APPROVED [Signature]	DRAWING NO. D3140	SHEET 6 OF 7
DATE 05.11.23		TITLE DOOR	SCALE NTS

NO. 21379
WORK ORDER
SHOP COPY
RETURN TO
ENGINEERING
UNCONTROLLED COPY
SUBJECT TO AMENDMENT
WITHOUT NOTICE

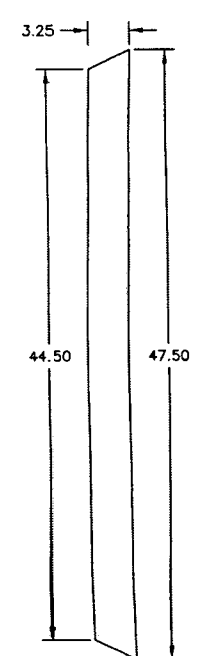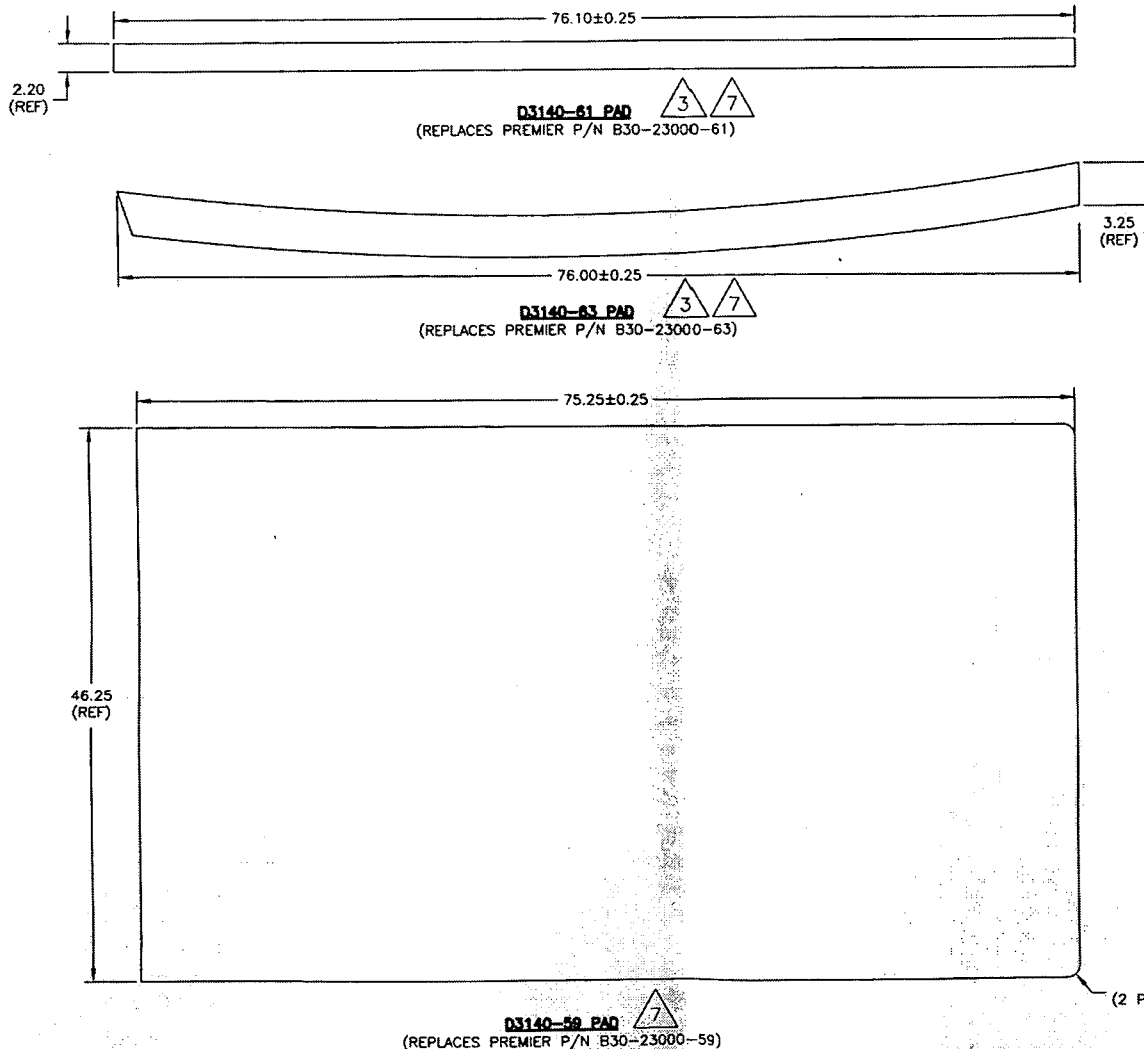

RELEASED
05.11.23

COPYRIGHT © 2002 BY DART AEROSPACE LTD.		DESIGN DS	DRAWN BY RF	DART	DART AEROSPACE LTD. WILKESBURY, ONTARIO, CANADA
THIS DOCUMENT IS PRIVATE AND CONFIDENTIAL AND IS SUPPLIED ON THE EXPRESS CONDITION THAT IT IS NOT TO BE USED FOR ANY PURPOSE OR COPIED OR COMMUNICATED TO ANY OTHER PERSON WITHOUT WRITTEN PERMISSION FROM DART AEROSPACE LTD.		CHECKED H	APPROVED H	DRAWING NO. D3140	REV. D SHEET 7 OF 7
DATE 05.11.23		TITLE DOOR		SCALE NTS	

WORK ORDER
NO. 27379
SHOP COPY
RETURN TO
ENGINEERING
UNCONTROLLED COPY
SUBJECT TO AMENDMENT
WITHOUT NOTICE

